



Sawgrass Centre

1601 Sawgrass Centre

Suite 110 | 6,607 s.f.



SAWGRASS
CENTRE

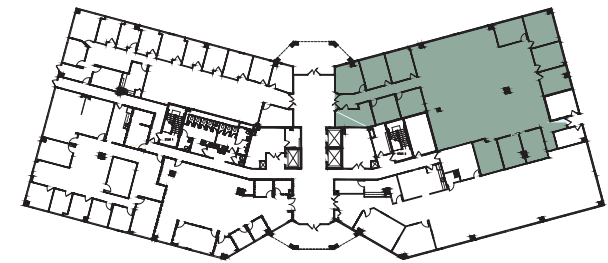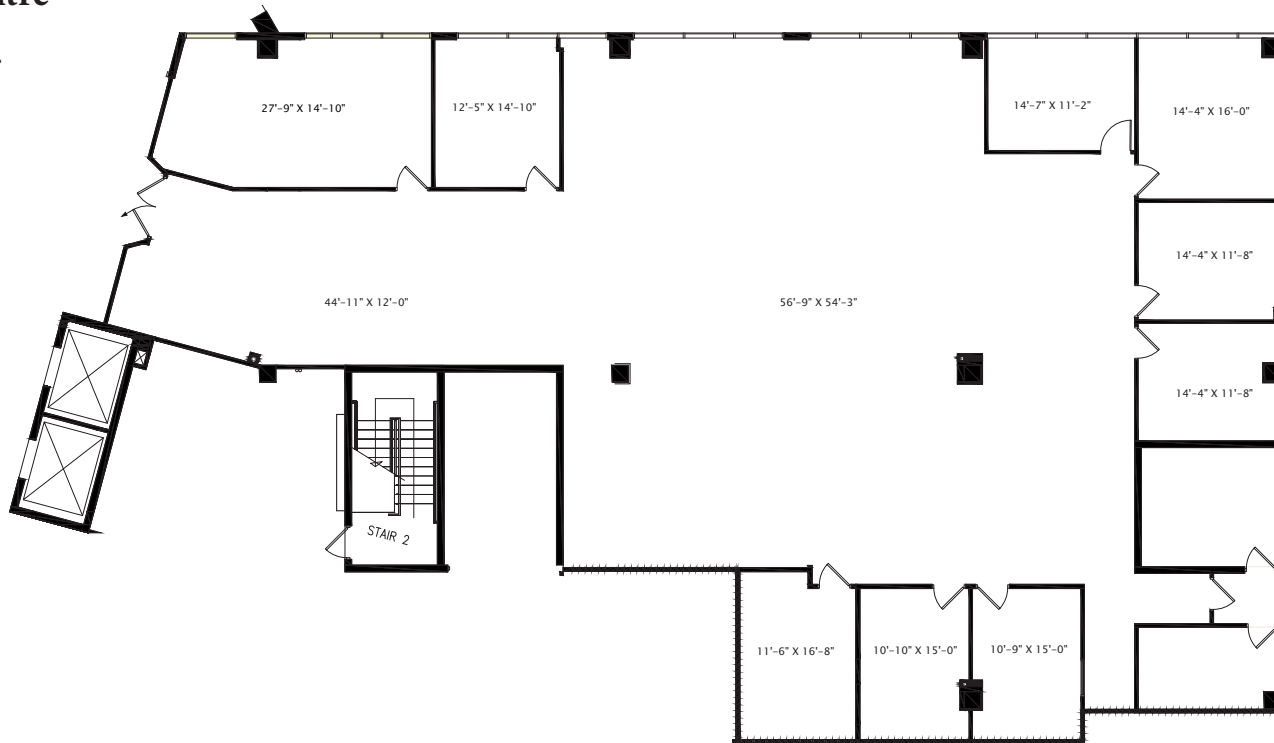

WWW.SAWGRASSCENTRE.COM

Sandra Andersen,
Senior Vice President

+1 954 760 4854
sandra.andersen@am.jll.com

Elizabeth Jimenez,
Brokerage Associate

+1 954 233 3441
elizabeth.jimenez@am.jll.com



Although information has been obtained from sources deemed reliable, Owner, Jones Lang LaSalle, and/or their representatives, brokers or agents make no guarantees as to the accuracy of the information contained herein, and offer the Property without express or implied warranties of any kind. The Property may be withdrawn without notice. If the recipient of this information has signed a confidentiality agreement regarding this matter, this information is subject to the terms of that agreement. ©2016, Jones Lang LaSalle. All rights reserved.